


Legend	
Terminal	Description
-X4:1	Line
-X4:2	Line
-X4:3	Pre-Warning
-X4:4	Pre-Warning
-X4:5	X-Ray On
-X4:6	X-Ray On
-X4:11	Com
-X4:12	Stand by

Legend	
Terminal	Description
-X4:14	Nominal/actual
-X4:15	Fault
-X4:17	PE

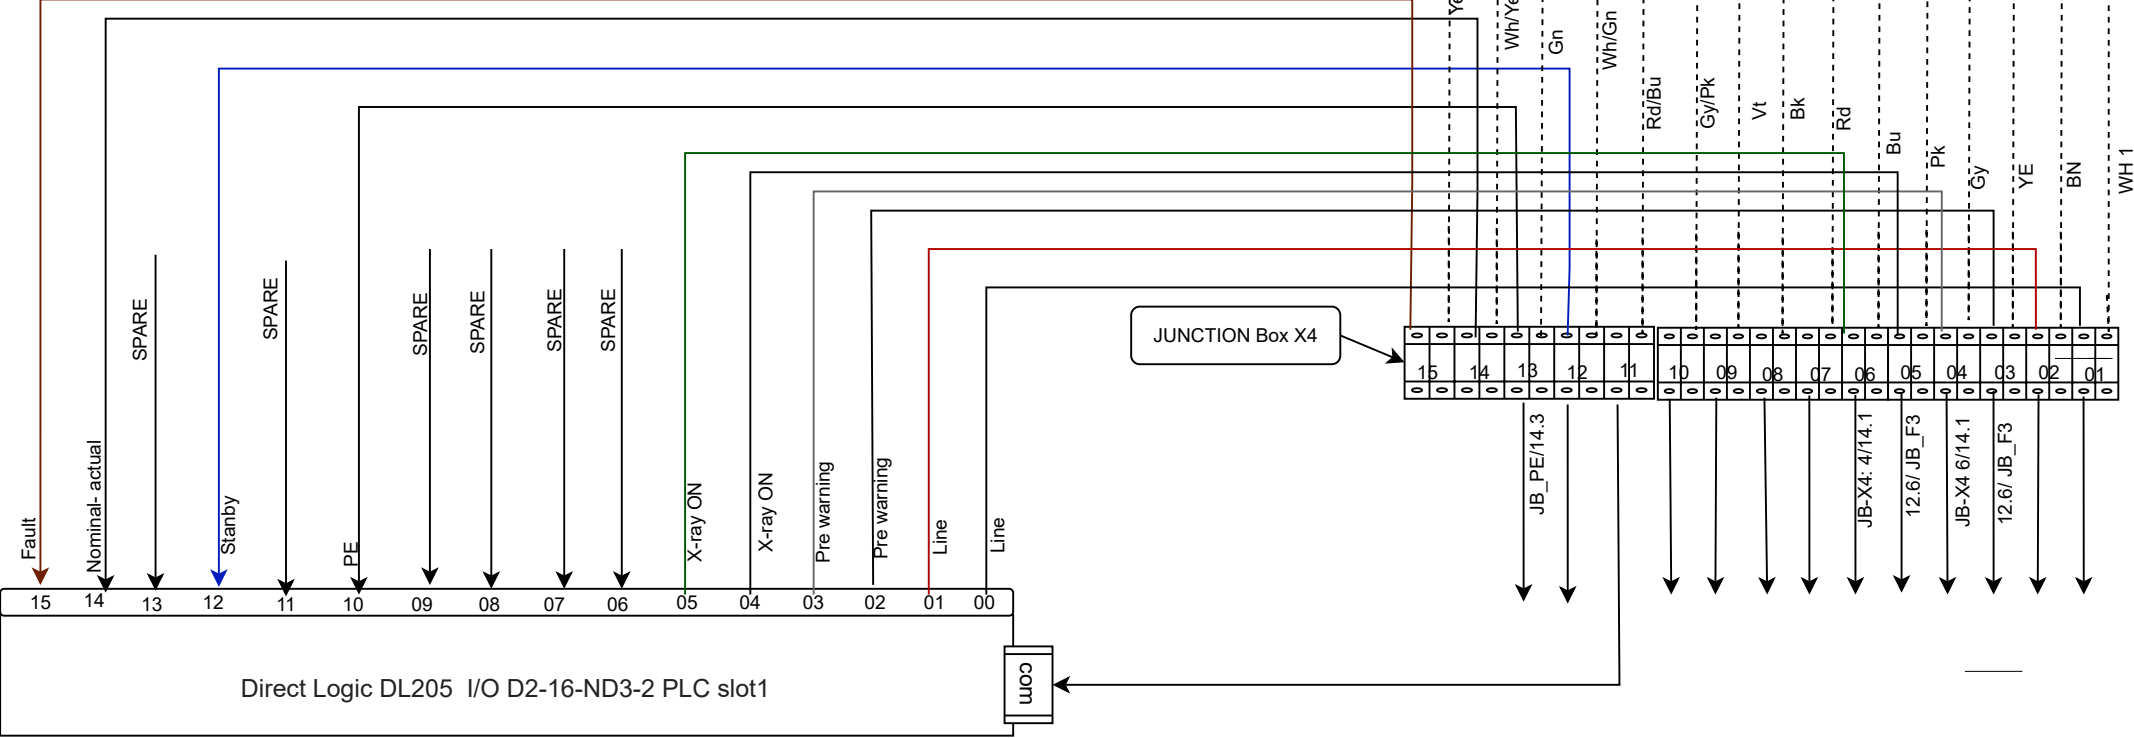

Peaxy Drawing			<div>PEAXY Inc Automation Specialist 2390 Bering Drive San Jose California 95131</div>	TITLE		<div>Drawing No. 217127/A 386-002-300 Pge 13</div> <div>Page 1</div>
1	As built	Jan-2023		PH1 PLC control X-ray		
Issue	Amendment	Date				