


Legend	
Terminal	Description
_X3:1	Contact door TK1
-X3:2	External start
-X3:3	External stop
-X3:4	Door contactTK1
-X3:5	Door contactTk2
-X3:9	Emmergency stop
-X3:10	emmergency stop2

Legend	
Terminal	Description
-X3:15	shutter not closed
-X3:16	Ground
	↑

X-Ray

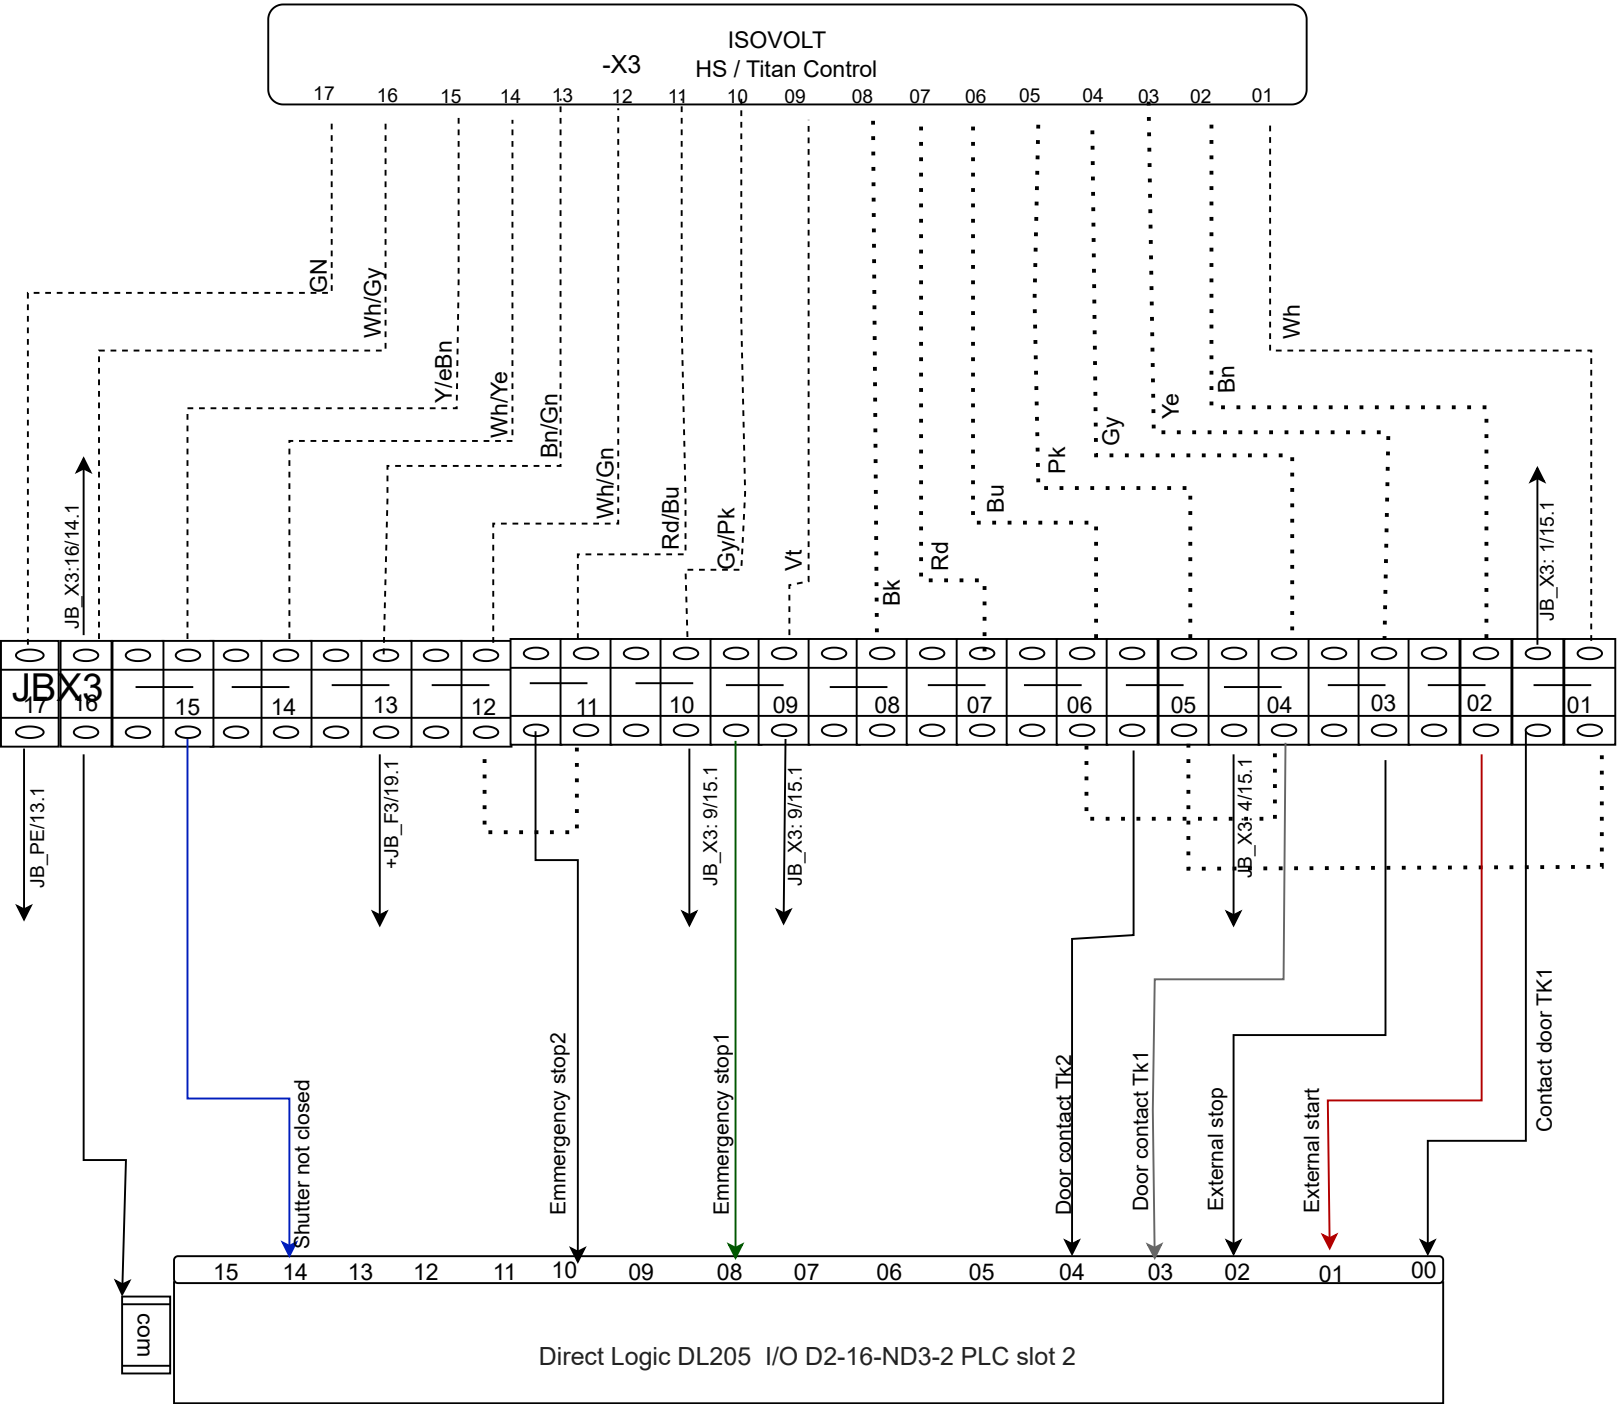

Peaxy Drawing			<div>PEAXY Inc Automation Specialist 2390 Bering Drive San Jose California 95131</div>	TITLE		<div>Drawing No. 217127/A 386-002-300 Pge 12</div> <div>Page 2</div>
1	As built	Jan-2023		PH1 PLC control X-ray		
Issue	Amendment	Date				

